
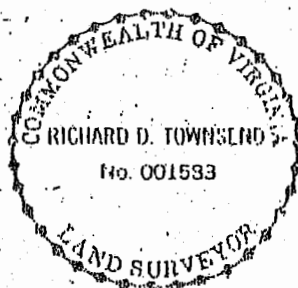


NOTES:

1. FENCE LOCATIONS, IF SHOWN, ARE APPROXIMATE ONLY AND DO NOT CERTIFY AS TO OWNERSHIP.
2. ACCORDING TO THE U.S. DEPARTMENT OF HOUSING AND URBAN DEVELOPMENT'S FLOOD INSURANCE RATE MAP, THE HOUSE SHOWN HEREON APPEARS TO BE IN ZONE: A B C
3. NO TITLE REPORT FURNISHED. PLAT SUBJECT TO RESTRICTIONS AND EASEMENTS OF RECORD.
4. IFF - IRON PIPE FOUND
UP - UTILITY POLE

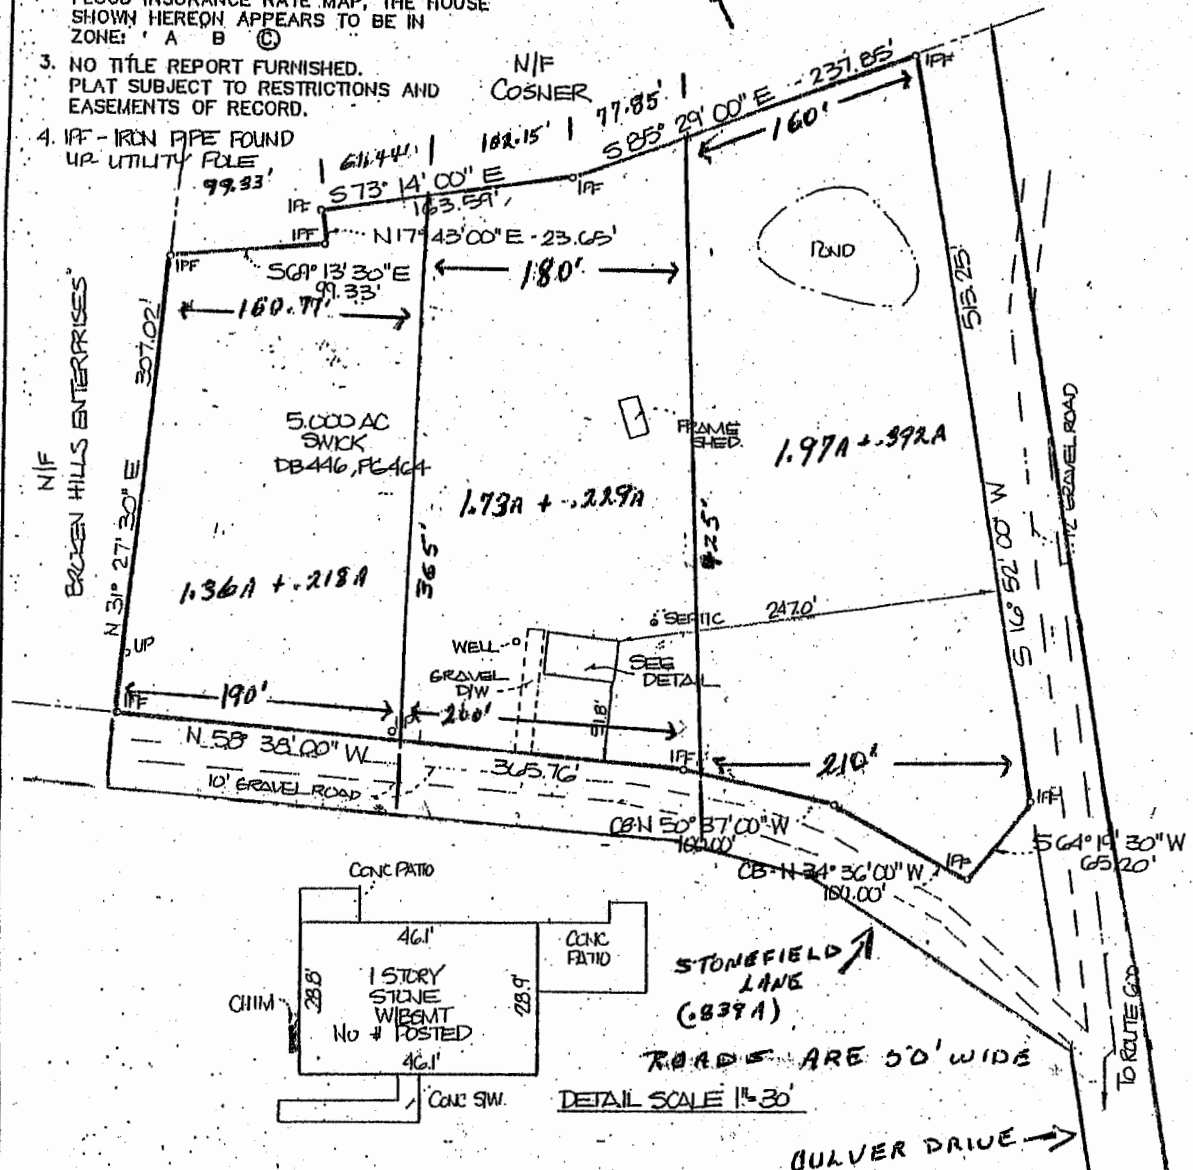

HOUSE LOCATION SURVEY
ON THE PROPERTY OF
WILLIAM P. & ISABELLE SWICK

CENTER DISTRICT
FAUQUIER COUNTY, VIRGINIA

RED LINES & FIGURES ARE APPROXIMATE

SCALE: 1"=100'

DATE: 17 FEBRUARY 1989

SURVEYOR'S CERTIFICATE

I HEREBY CERTIFY THAT THE POSITIONS OF ALL THE EXISTING IMPROVEMENTS HAVE BEEN CAREFULLY ESTABLISHED BY A TRANSIT TAPE SURVEY AND UNLESS OTHERWISE SHOWN THERE ARE NO ENCROACHMENTS EITHER WAY ACROSS THE PROPERTY LINE.

[Signature]
CERTIFIED LAND SURVEYOR



ARLOVER & ASSOCIATES

9252 MOSBY STREET MANASSAS, VA 22
(703) 368-8001 OR 631-2995

TAX MAP NUMBER: 65-41F

CASE NAME: SWICK

DRFT BY: E